


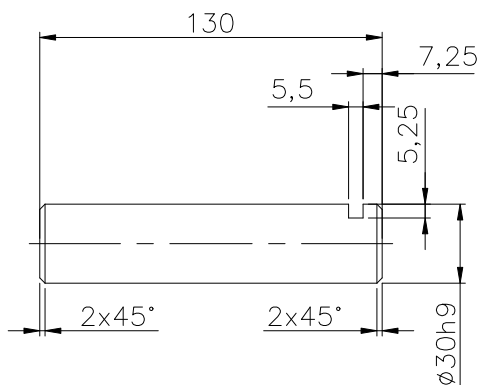

AS BUILT

Released for manufacturing Liberado para Fabricação	
Date/Data	
signed/por	

This drawing is our intellectual property. It must not be reproduced nor transferred to or brought within the reach of third parties without our written permission. Likewise, the receiver is not allowed to use this drawing as a basis for manufacture. Violation of the above conditions will result in legal prosecution.
VOEST-ALPINE Materials Handling GmbH & Co KG ZELTWEG

DIMENSIONAL TOLERANCES unless otherwise specified Variations in mm										
Nominal dimensions mm	0.5 to 3	over 3 to 6	over 6 to 30	over 30 to 120	over 120 to 315	over 315 to 1000	over 1000 to 2000	over 2000 to 4000	over 4000 to 8000	over 8000 to 12000
Permissible variations		±0.05	±0.05	±0.1	±0.15	±0.2	±0.3	±0.5		
		±0.1	±0.1	±0.2	±0.3	±0.5	±0.8	±1.2	±2	±4
			±0.2	±0.5	±0.8	±1.25	±2	±3	±4	±6
TOLERANCIA DIMENSIONAIS caso não especificadas Tolerancias em mm										
Dimensão Nominal mm	0.5 até 3	> 3 até 6	> 6 até 30	> 30 até 120	> 120 até 315	> 315 até 1000	> 1000 até 2000	> 2000 até 4000	> 4000 até 8000	> 8000 até 12000
Tolerancias Admissíveis		±0.05	±0.05	±0.1	±0.15	±0.2	±0.3	±0.5		
		±0.1	±0.1	±0.2	±0.3	±0.5	±0.8	±1.2	±2	±4
			±0.2	±0.5	±0.8	±1.25	±2	±3	±4	±6

NOTAS

1 - XXXX

DESENHOS DE REFERÊNCIA

-DF-313T-46-0102/46-2311 - CHUTE DE RECEBIMENTO

3	20.06.05	G	WRS		AS BUILT
2	08.10.04	E	WRS		DES. CERTIFICADO, LIBERADO P/ FABRICAÇÃO E MONTAGEM
1	02.2004	A	WI		PARA APROVAÇÃO
0	11.2003	A	WI		EMIÇÃO INICIAL
REV.	DATA	TIPO	POR	SOLICIT.	DESCRIÇÃO

REVISÕES

TIPO DE EMISSÃO	(A) PRELIMINAR	(D) PARA COTAÇÃO	(G) CONFORME CONSTRUÍDO
	(B) PARA APROVAÇÃO	(E) PARA CONSTRUÇÃO	(H) CANCELADO
	(C) PARA CONHECIMENTO	(F) CONFORME COMPRADO	



COMPLEXO DE TUBARÃO



TERMINAL DE MINÉRIOS
PÁTIO DE ESTOCAGEM - PÁTIO J / PÁTIO P
SISTEMA DO TRANSPORTADOR DA LANÇA
PARAFUSO DIA 30 x 130 - ER-02 & 03

RESPONSÁVEL		DATA	
PROJ.	VAMH	02.2004	
DES.	BEKO	02.2004	
VER.	RIEGER		
APROV.	WIECZOREK		
ESCALA 1:2	N° CVRD: DF-313T-46-0102/46-2354	REV. 3	
SE N°	N. VAMH: 415.54653.000	FOLHA 1	